


DART~~SUPERCEDED BY~~


Rev. B 04.11.24 04.11.24

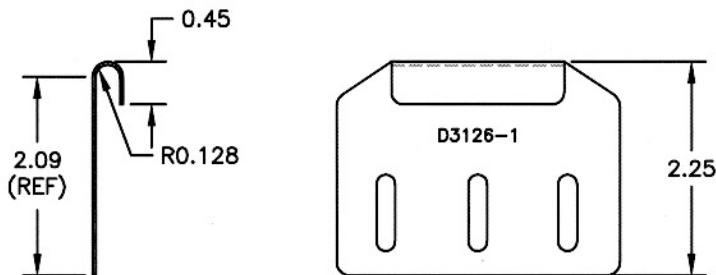

DESIGN	DRAWN BY	DART AEROSPACE LTD	
	RF	HAWKESBURY, ONTARIO, CANADA	
CHECKED	APPROVED	DRAWING NO.	REV. A
		D3126	SHEET 1 OF 3
DATE	TITLE		SCALE
02.04.17	BRACKET		1:2
A	02.04.17	NEW ISSUE	
AI	02.09.23	ADD "ANNEALED" SPEC	

RELEASED
 02.05.27


D3126-1 BRACKET
REPLACES PREMIER P/N B30-23000-265

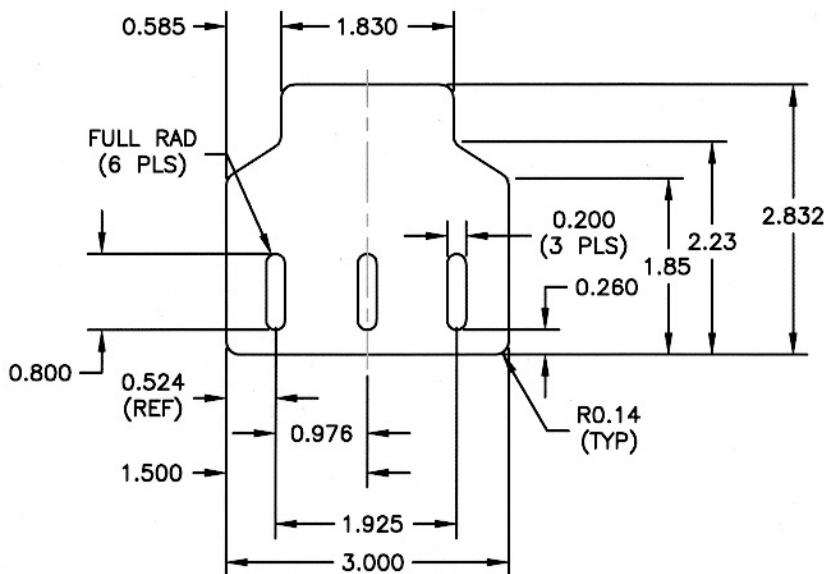


D3126-1 BRACKET FLAT PATTERN

NOTES


- 1) MATERIAL: AISI 304/316 SS SHEET 0.032 THICK PER MIL-S-5059 (REF. DART SPEC. M304S) ANNEALED
- 2) TOLERANCES ARE PER DART QSI 018 UNLESS OTHERWISE NOTED
- 3) ALL DIMENSIONS ARE IN INCHES
- 4) BREAK ALL SHARP EDGES 0.005 TO 0.010
- 5) SCRIBE DART P/N D3126-1 AS SHOWN

DART

DESIGN	DRAWN BY	DART AEROSPACE LTD HAWKESBURY, ONTARIO, CANADA	
CHECKED	APPROVED	DRAWING NO.	REV. A
		D3126	SHEET 2 OF 3

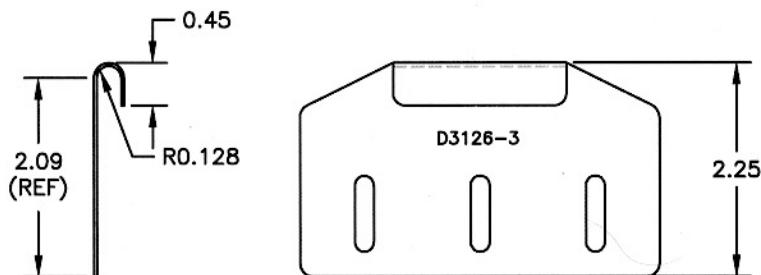DATE
02.04.17TITLE
BRACKETSCALE
1:2
RELEASED
 02.05.27 ~~RF~~


D3126-3 BRACKET
REPLACES PREMIER P/N B30-23000-267

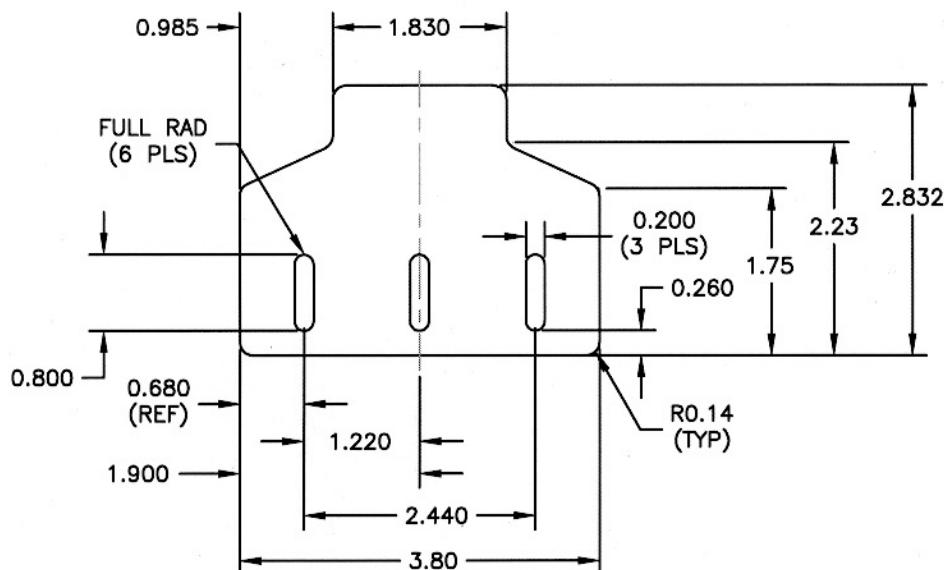

D3126-3 BRACKET FLAT PATTERN


NOTES

- 1) MATERIAL: AISI 304/316 SS SHEET 0.032 THICK PER MIL-S-5059 (REF. DART SPEC. M304S) ~~ANNEALED~~
- 2) TOLERANCES ARE PER DART QSI 018 UNLESS OTHERWISE NOTED
- 3) ALL DIMENSIONS ARE IN INCHES
- 4) BREAK ALL SHARP EDGES 0.005 TO 0.010
- 5) SCRIBE DART P/N D3126-3 AS SHOWN


DART

DESIGN	DRAWN BY	DART AEROSPACE LTD HAWKESBURY, ONTARIO, CANADA	
CHECKED	APPROVED	DRAWING NO.	REV. A
		D3126	SHEET 3 OF 3

DATE 02.04.17 TITLE BRACKET SCALE 1:2

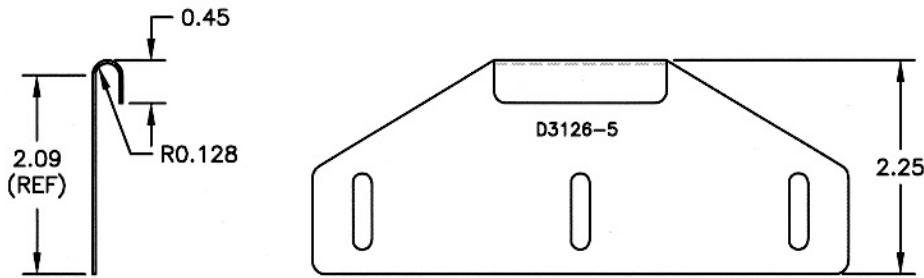RELEASED
 02.05.27 *AF*


D3126-5 BRACKET
REPLACES PREMIER P/N B30-23000-269

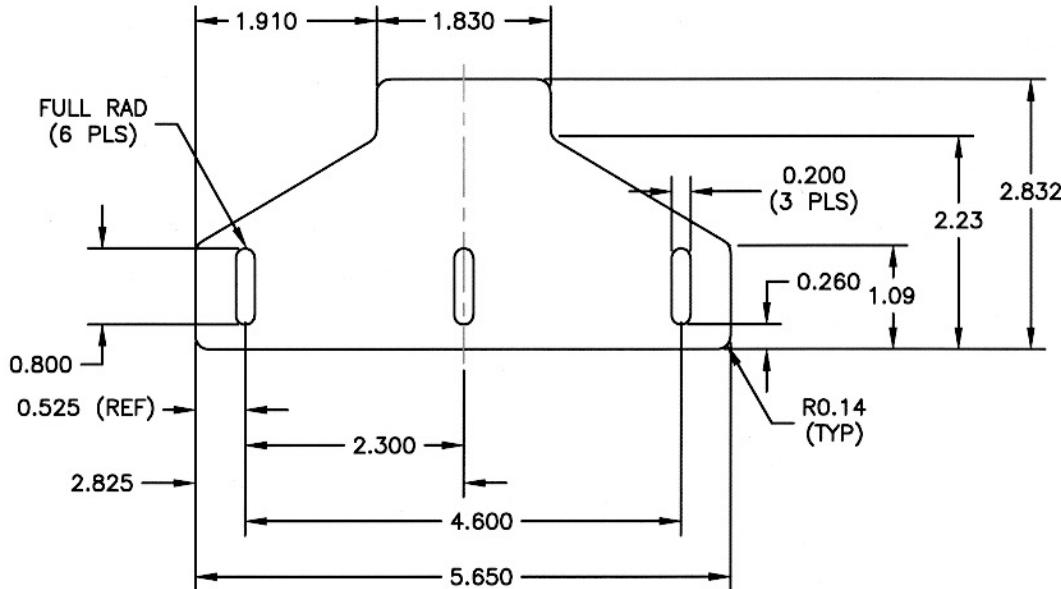

D3126-5 BRACKET FLAT PATTERN

NOTES

- 1) MATERIAL: AISI 304/316 SS SHEET 0.032 THICK PER MIL-S-5059 (REF. DART SPEC. M304S) ANNEALED
- 2) TOLERANCES ARE PER DART QSI 018 UNLESS OTHERWISE NOTED
- 3) ALL DIMENSIONS ARE IN INCHES
- 4) BREAK ALL SHARP EDGES 0.005 TO 0.010
- 5) SCRIBE DART P/N D3126-5 AS SHOWN